SCHILLING SQUARE

215 SCHILLING CIRCLE HUNT VALLEY, MD 21031

SUITE 104-105

TOTAL SF AVAILABLE -5,820 SF

OFFICE - 5,820 SF

WAREHOUSE - 0,000 SF

Click to access **CADD file**

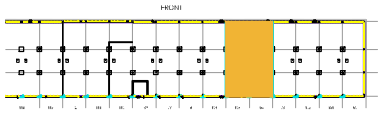

Key Plan

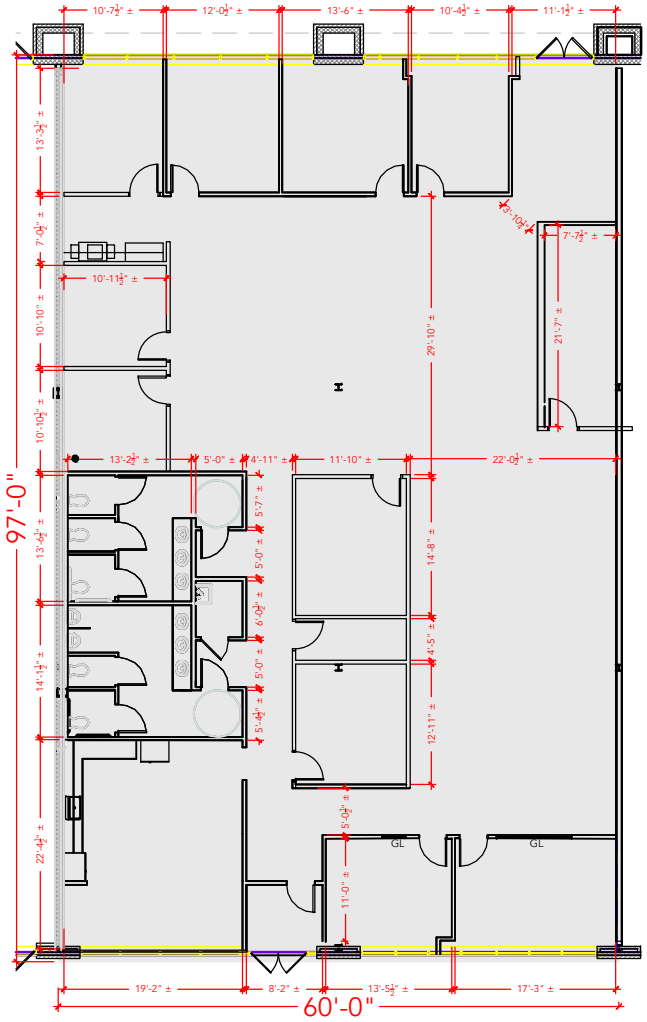

Floor Plan

PLAN NOT TO SCALE - THIS IS NOT A CONSTRUCTION DOCUMENT

DRAWING #: SC2-104-105 ASBUILT DATE: **NEEDS TO BE**